
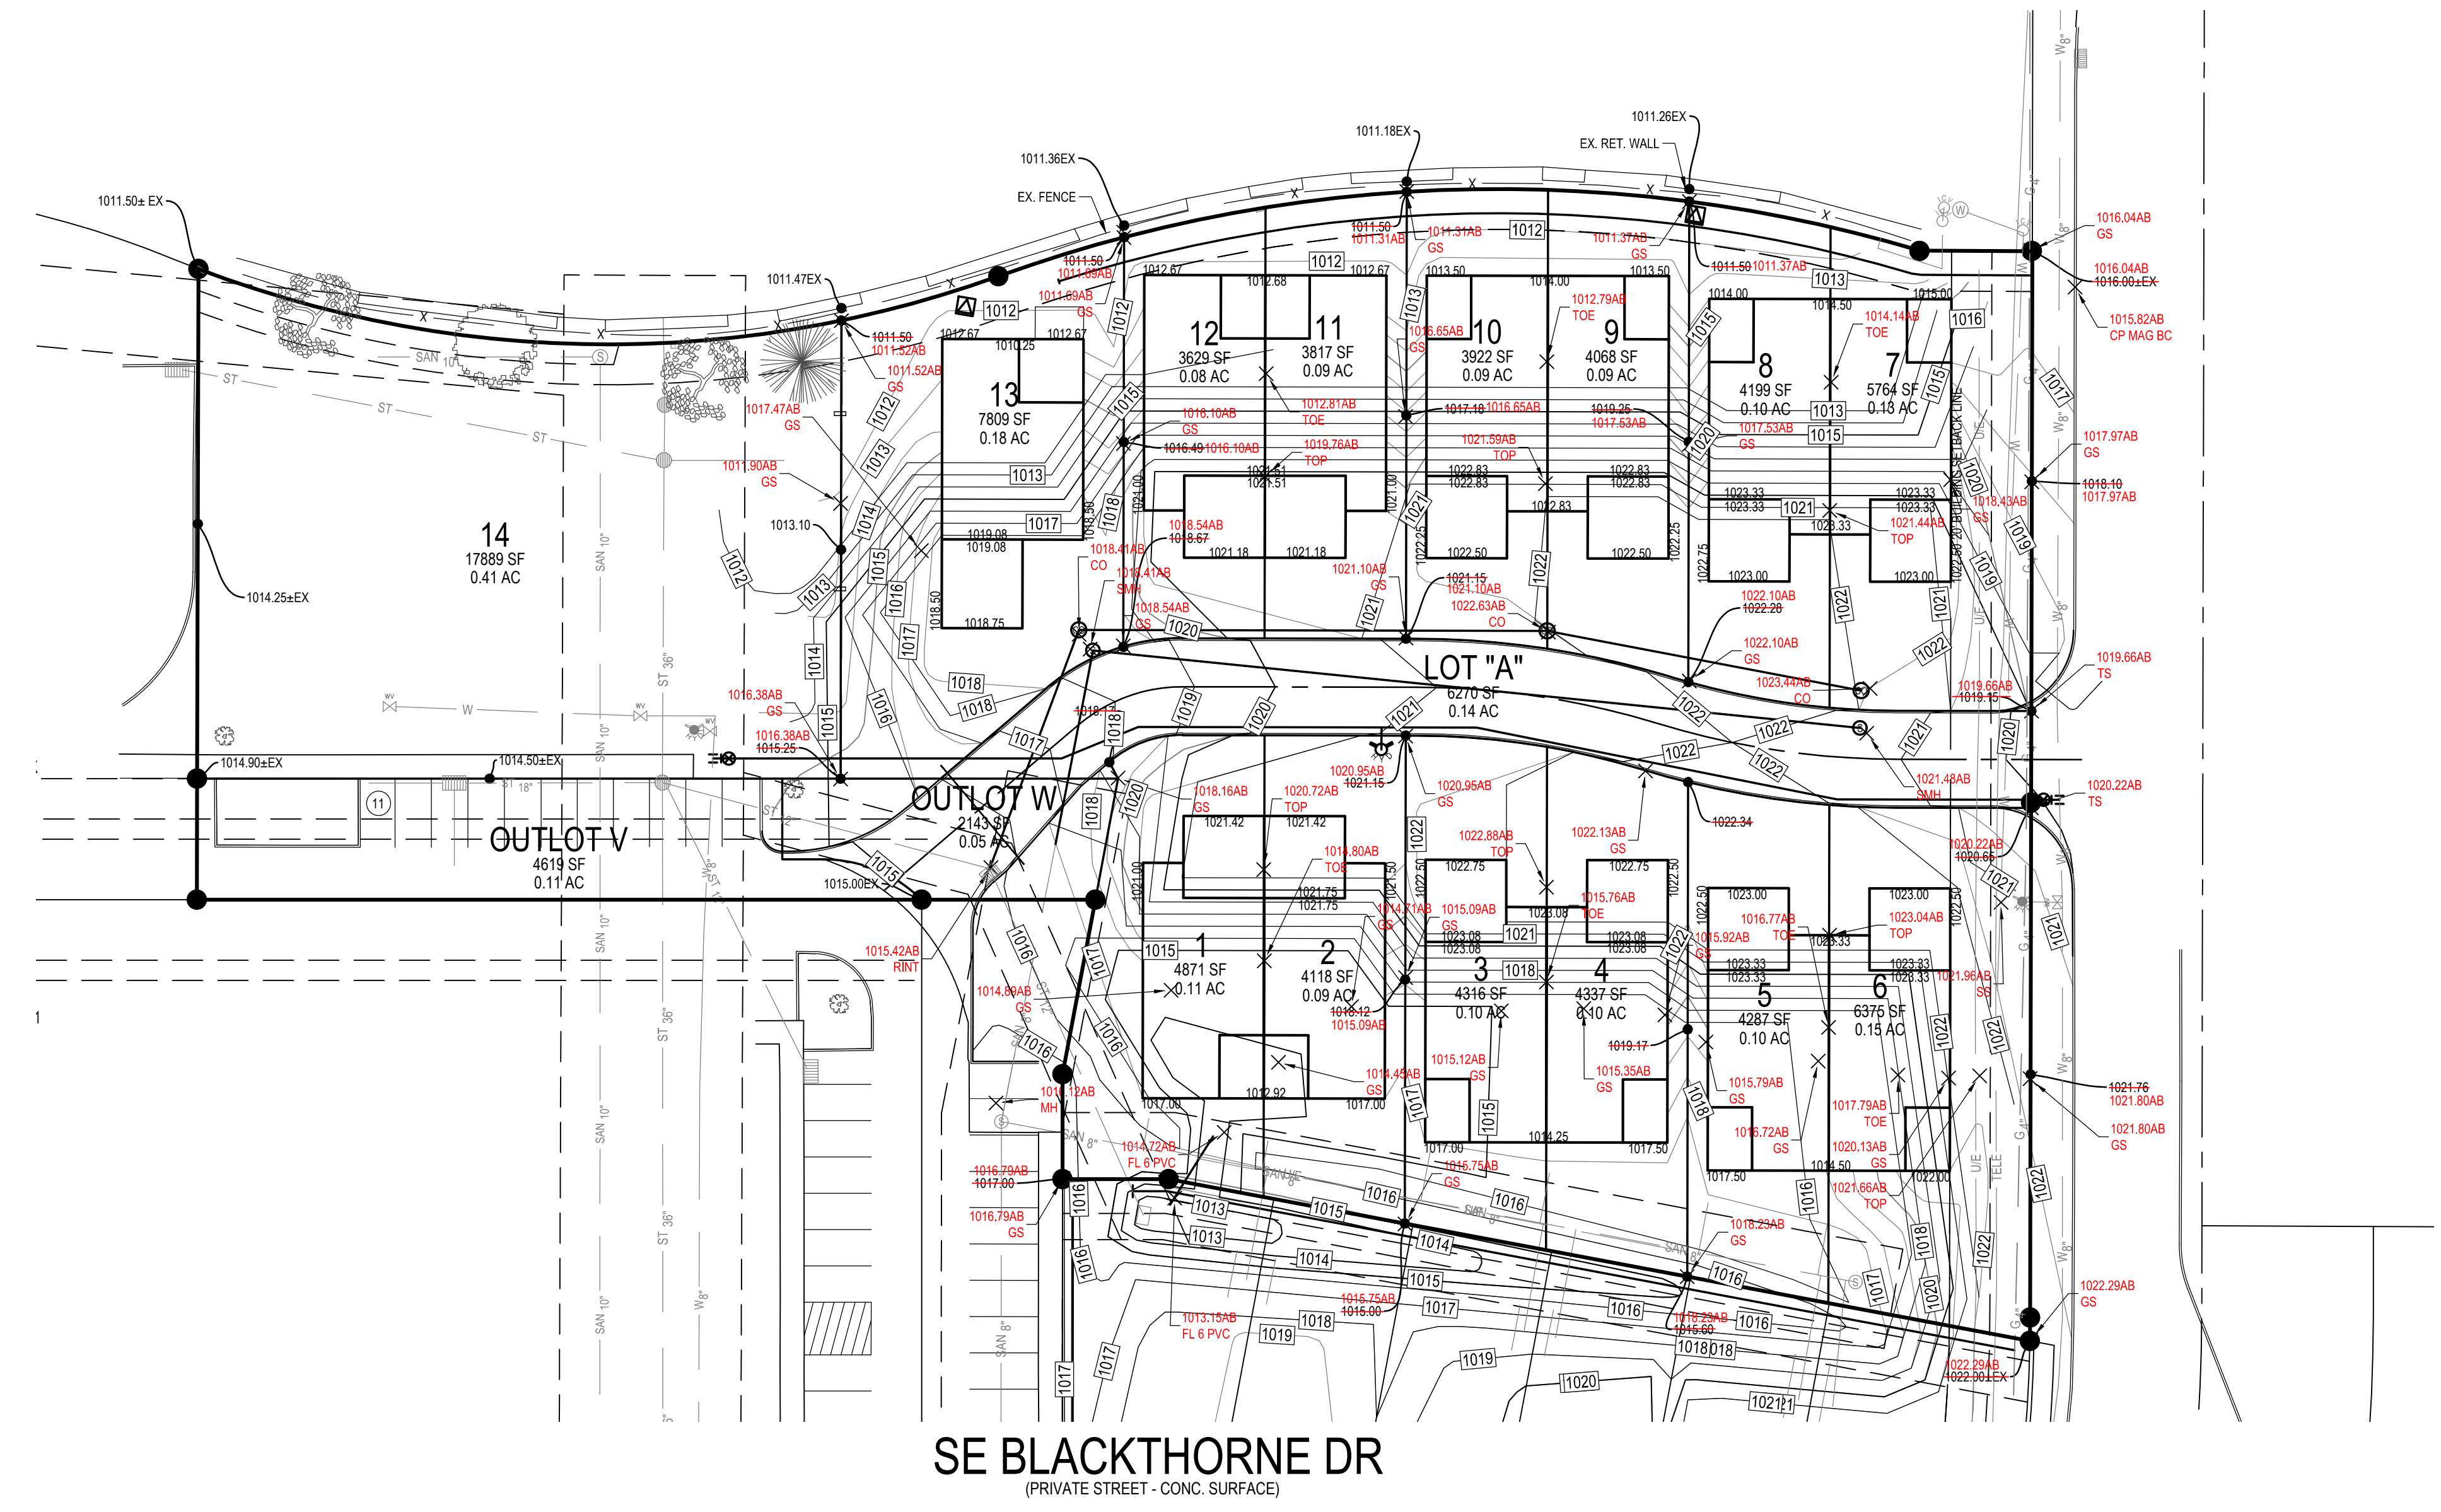
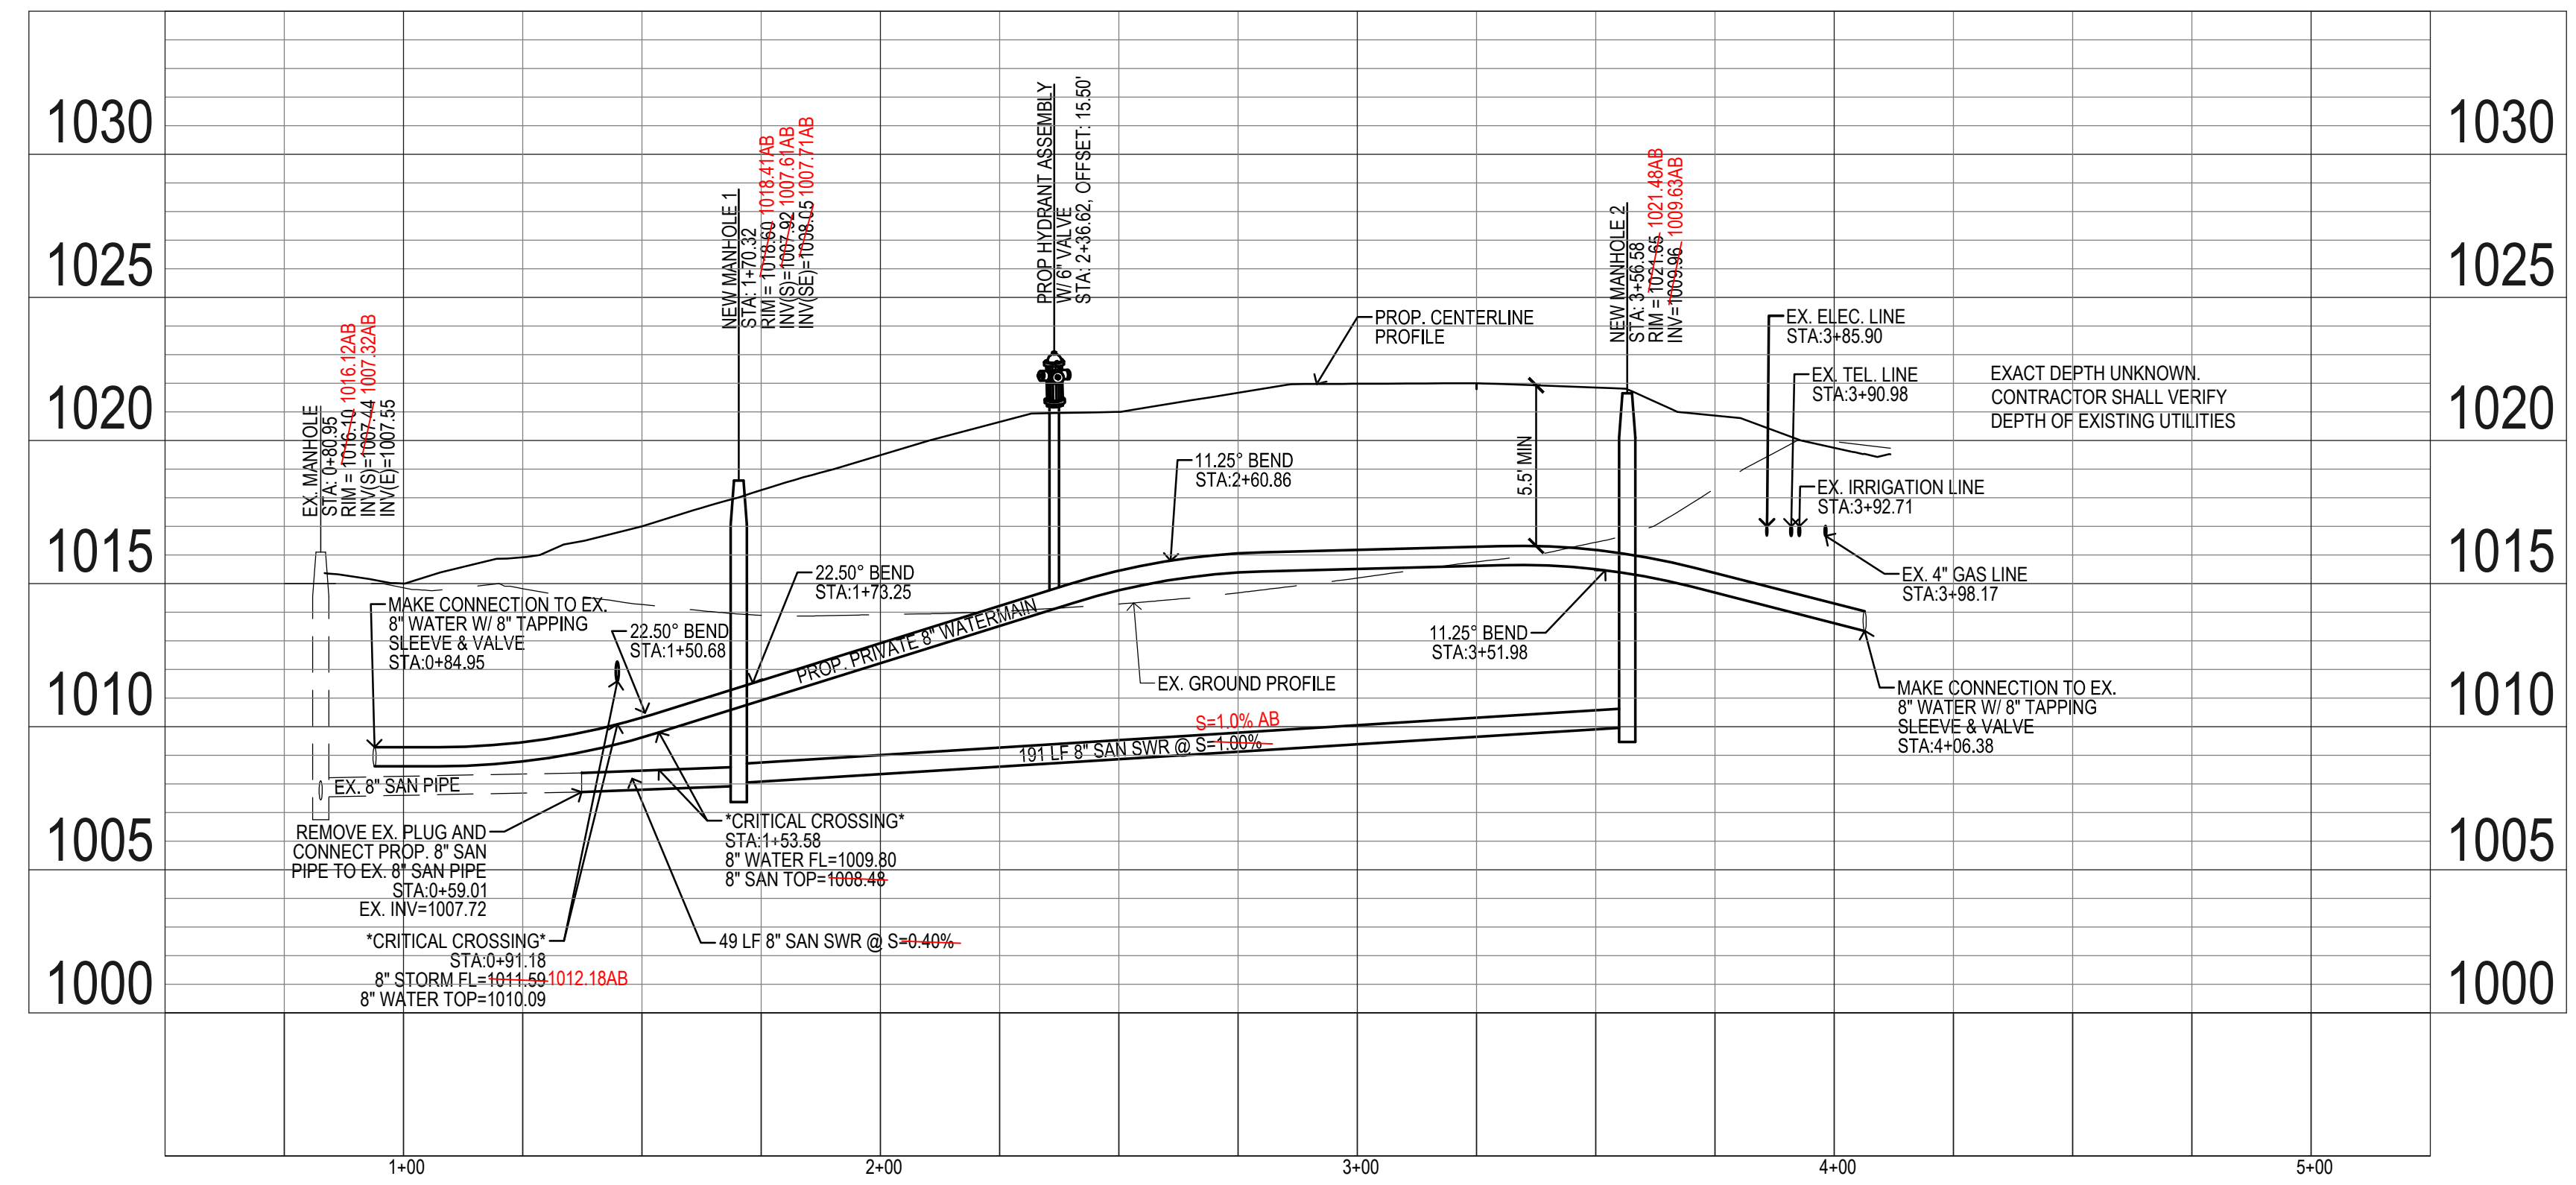


1/25/2018 5:05:38 PM M:\LAND PROJECTS\2016\160425DWG\AS-BUILT\AS-BUILT PLANS.DWG

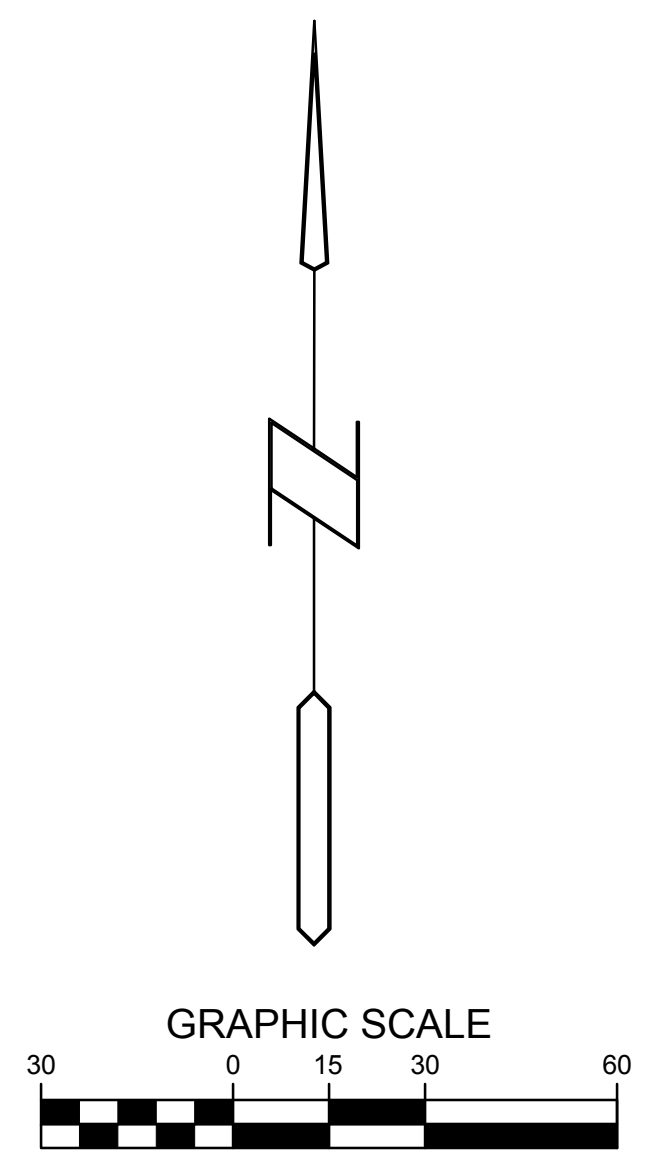

LEGACY POINTE AT WAUKEE PLAT 9 ASBUILT
WAUKEE, IOWA
SITE PLAN & PROFILE

REFERENCE NUMBER:	150593
DRAWN BY:	GSA
CHECKED BY:	SKV
REVISION DATE:	01-09-2018 01-23-2018
PROJECT NUMBER:	160425
SHEET NUMBER:	2 OF 2

AS-BUILT 1-25-2018